



Asbuilt 36" x 78.29 CMP @ 243+08.54

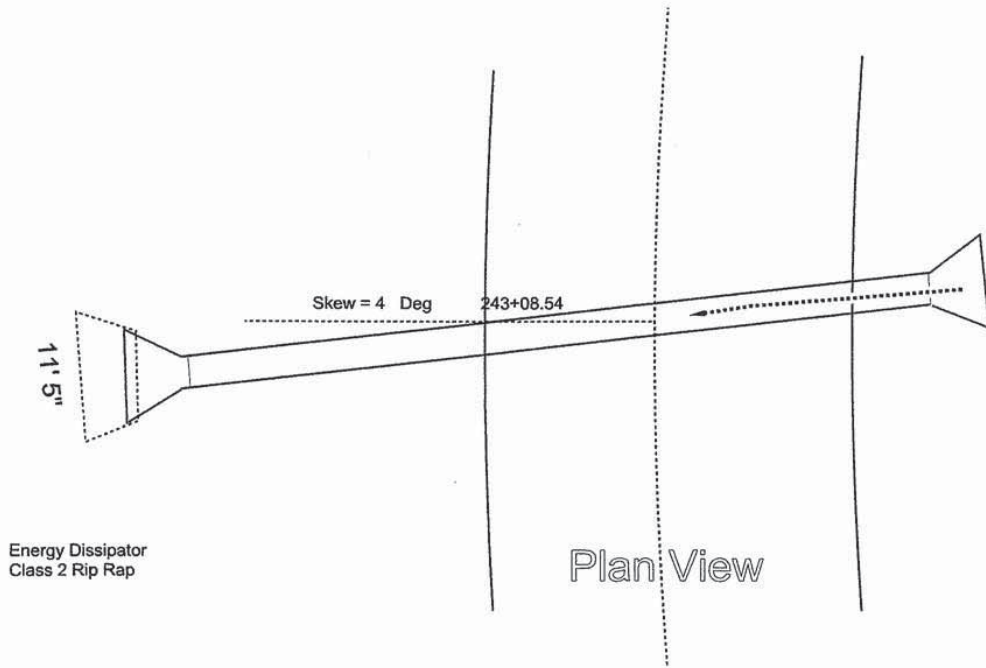

- Notes:
1. 78.29 CMP includes End Sections @ 5' Each
 2. 1 Energy Dissipator
 3. Template = Subgrade Elevations

Submitted By: _____
 Drawn By: DM
 8-10-2008
 Revised 8-26-2008 (New Data)

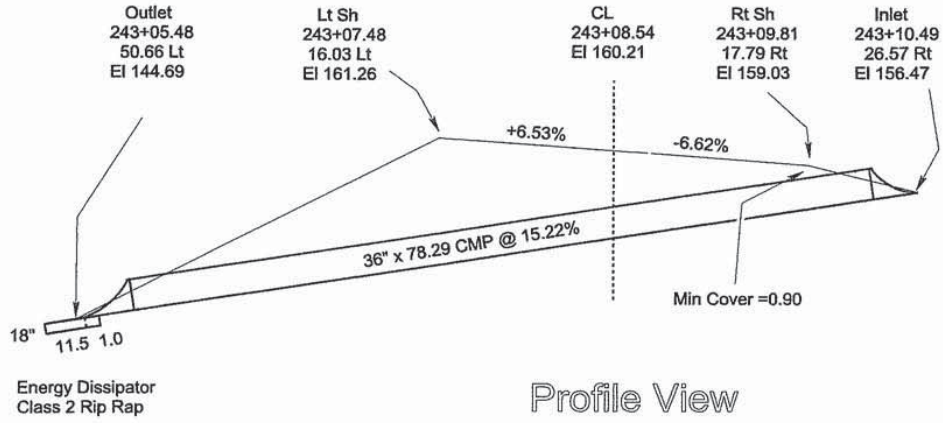